

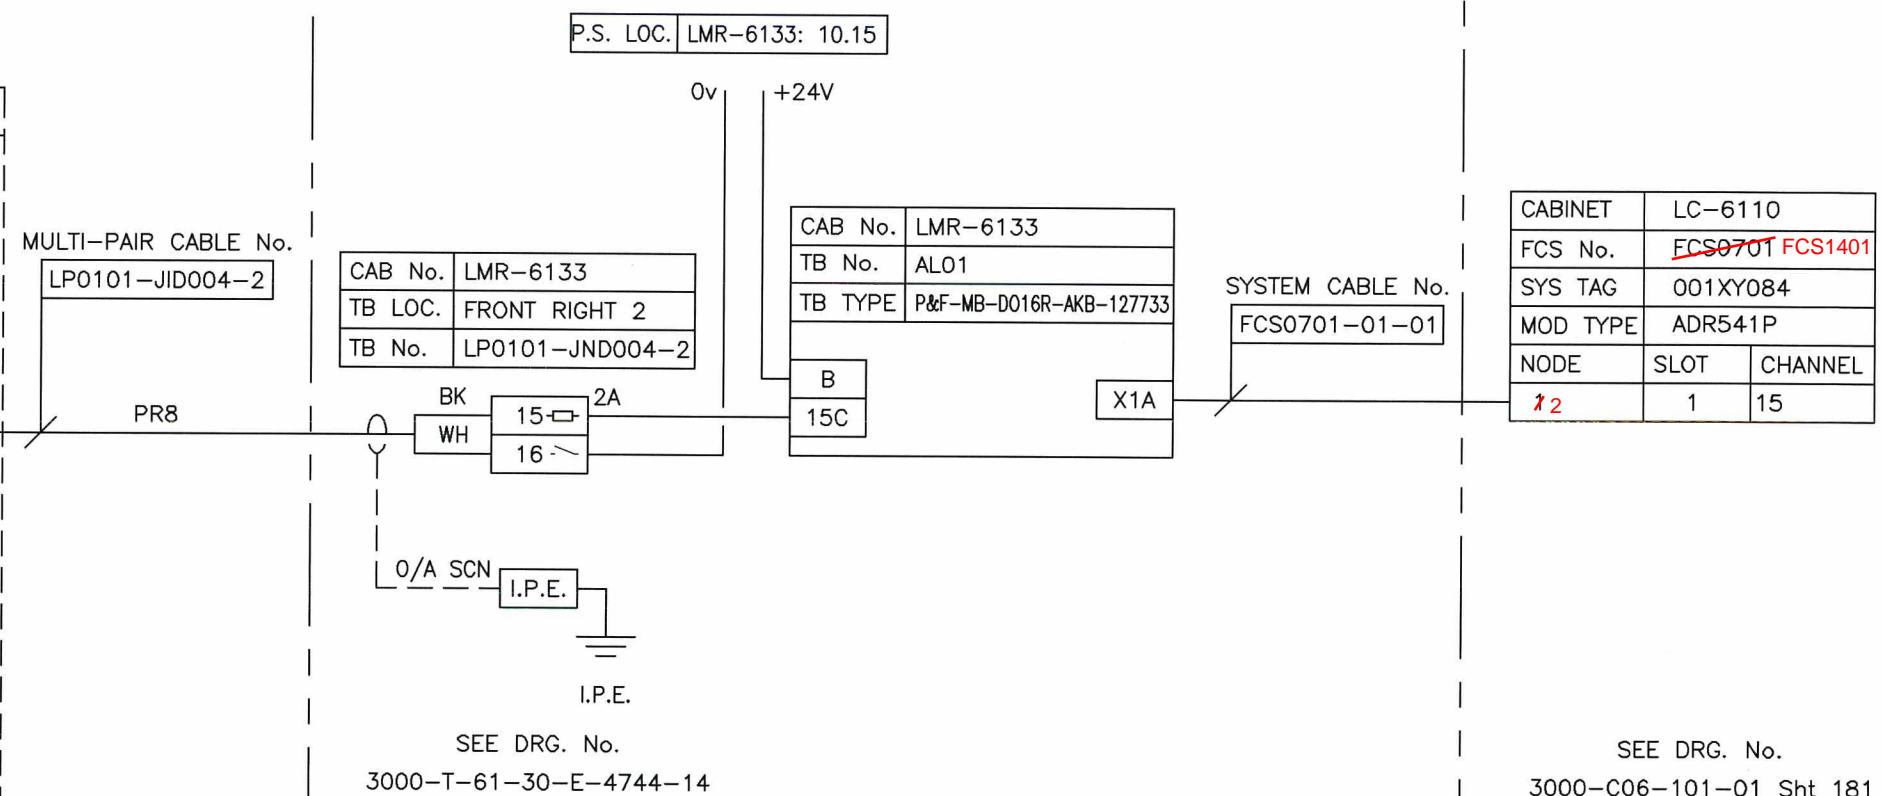
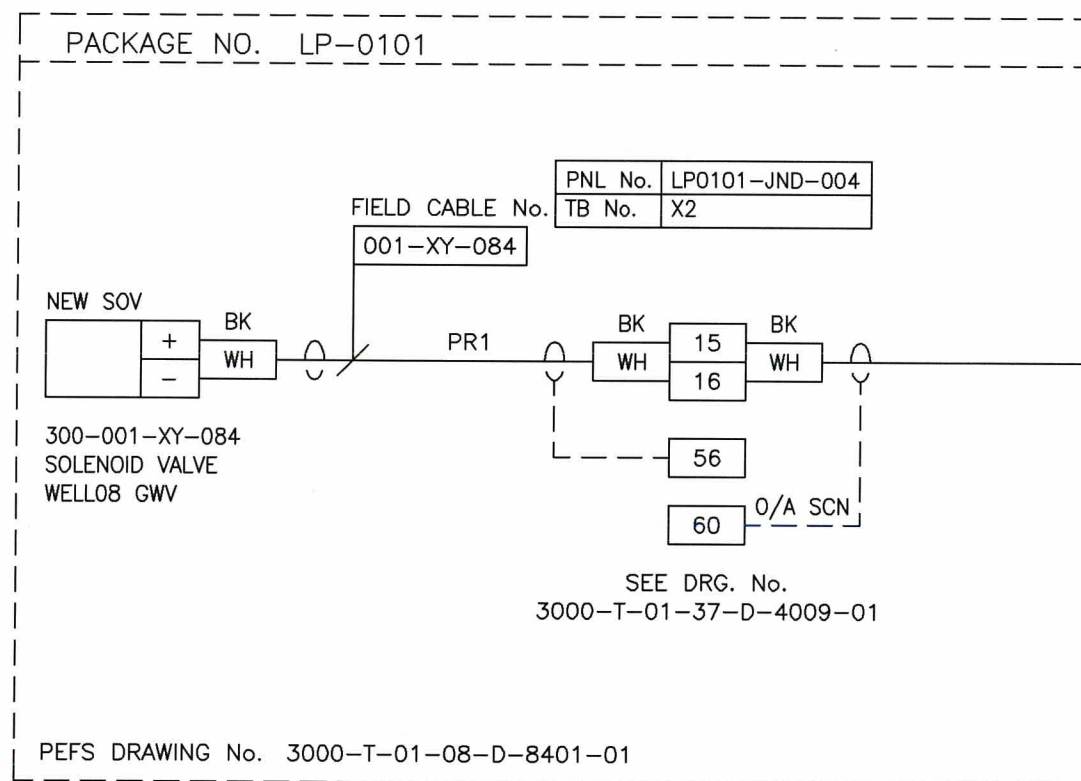
RED LINE MARK UP

NAME: Aleksandr Sverchkov

DATE: 16.06.2023



SIGNATURE: _____

DOC #: MoC #3000-2017-7491



LAYOUT DRAWING No. 3000-T-90-30-D-4118-01

GENERAL NOTES:

| | | | | | | | | | | | | | | | | |
|-------------|-------------------|--|----------------------|----------|-------|--------------|------|------|---|---|---|------------|-----------|--------------|-----------|----------|
| DRAWING NO. | REFERENCE DRAWING |  PSN Production Services Network | | | | SCALE N.T.S. | | | |  SAKHALIN ENERGY INVESTMENT CO. LTD. | FACILITY NAME: PILTUN – ASTOKHSKOYE FIELD PLATFORM 'B' | | | | | |
| | | | | | | JOB No. | | | | | | | | | | |
| | | REV. No. | DESCRIPTION | DATE | PREP. | CHK'D | APP. | SEIC | DRAWING TITLE: INSTRUMENT LOOP DIAGRAM 300-001-XY-084 | | | | | | | |
| | | XA | AS-BUILT FOR RU-6126 | 16.04.13 | RD | GLM | WC | | | | | | | | | |
| | | | | | | | | | | | | | | | | |
| | | | | | | | | | | | | | | | | |
| | | | | | | | | | PROJECT NO. | ORIGIN | MODULE | DISCIPLINE | DOC. TYPE | SEQUENCE NO. | SHEET NO. | REVISION |
| | | | | | | | | | 3000 | T | 01 | 30 | D | 4000 | 03 | XA |