


FIELD


MAIN EQUIPMENT ROOM

PCS MARSHALLING CABINET

PCS SYSTEM CABINET

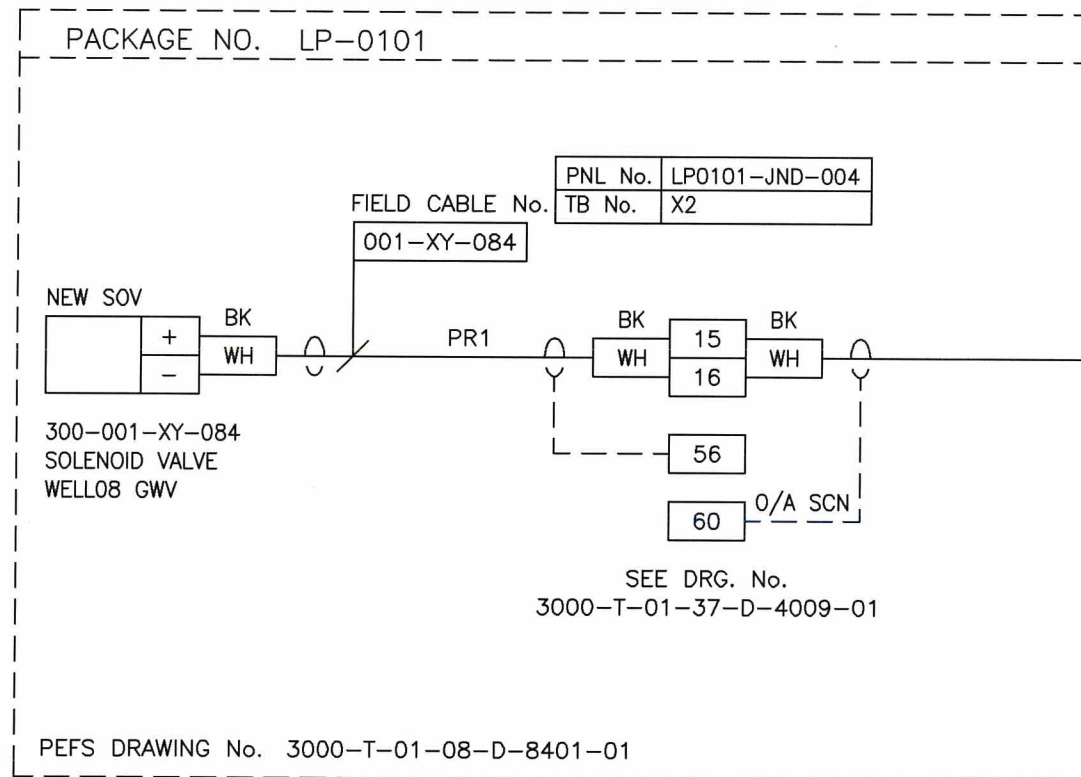

MULTI-PAIR CABLE No.  
LP0101-JID004-2

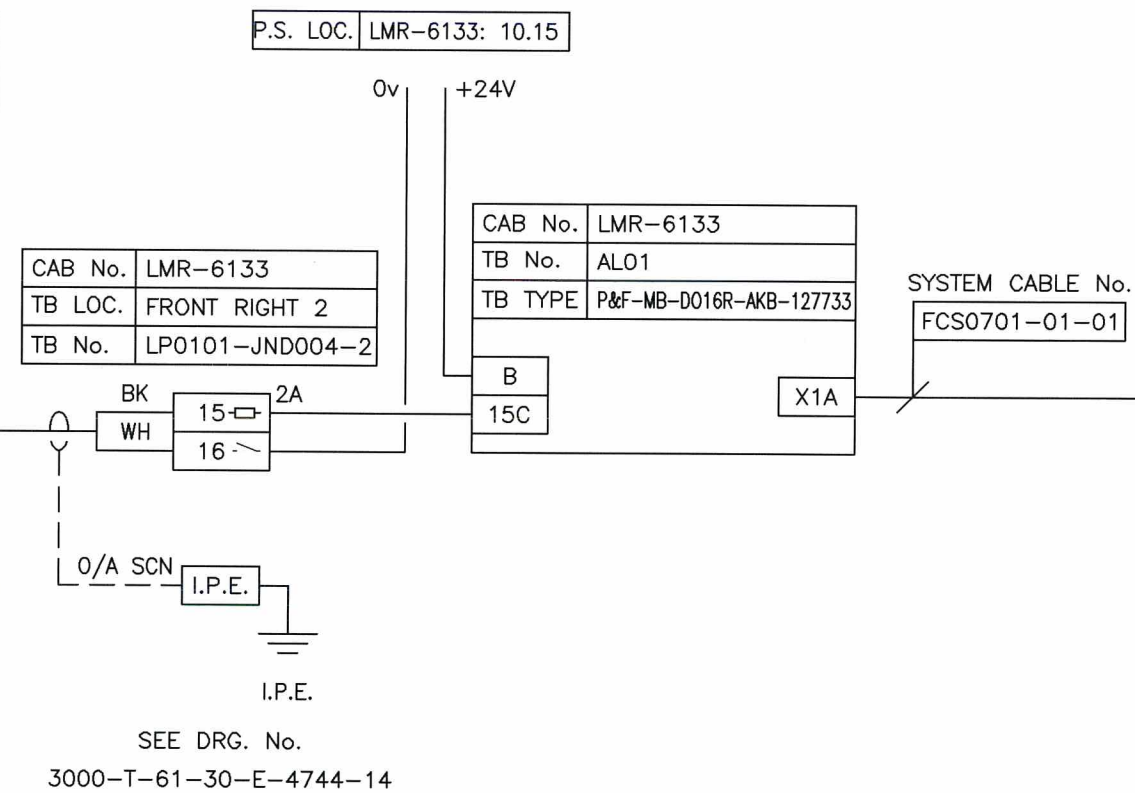

CABINET	LC-6110	
FCS No.	FCS0701	
SYS TAG	001XY084	
MOD TYPE	ADR541P	
NODE	SLOT	CHANNEL
1	1	15

SEE DRG. No.  
3000-C06-101-01 Sht 181

LAYOUT DRAWING No. 3000-T-90-30-D-4118-01

GENERAL NOTES:

DRAWING NO.	REFERENCE DRAWING	PSN Production Services Network	SCALE N.T.S.	FACILITY NAME:
REV. No.	DESCRIPTION	DATE	JOB No.	PILTUN - ASTOKHSKOYE
XA	AS-BUILT FOR RU-6126	16.04.13	RD BLM WC	FIELD PLATFORM 'B'
				DRAWING TITLE:
				INSTRUMENT LOOP DIAGRAM
				300-001-XY-084
				PROJECT NO. 3000
				ORIGIN T
				MODULE 01
				DISCIPLINE 30
				DOC. TYPE D
				SEQUENCE NO. 4000
				SHEET NO. 03
				REVISION XA