

FIELD

MAIN EQUIPMENT ROOM

PCS MARSHALLING CABINET

PCS SYSTEM CABINET

RED LINE MARK UP


NAME: Aleksandr Sverchkov

DATE: 16.06.2023

SIGNATURE: 

DOC #: MoC #3000-2017-7491


PACKAGE NO. LP-0101

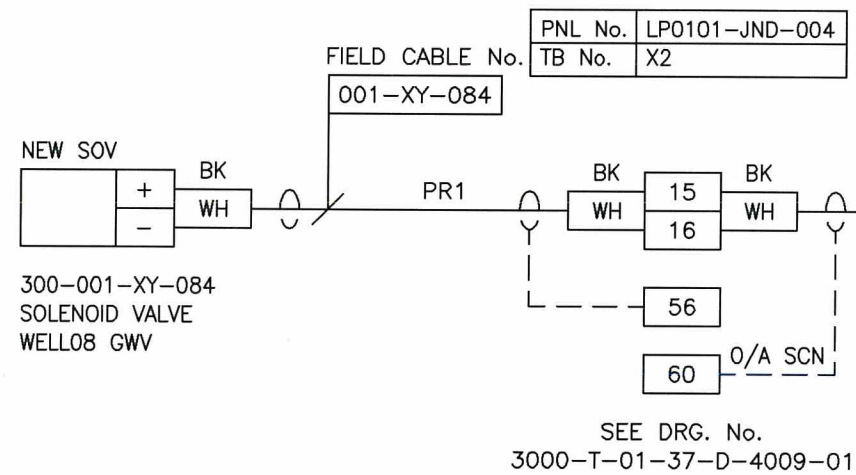

PEFS DRAWING No. 3000-T-01-08-D-8401-01

MULTI-PAIR CABLE No.
LP0101-JID004-2

PR8

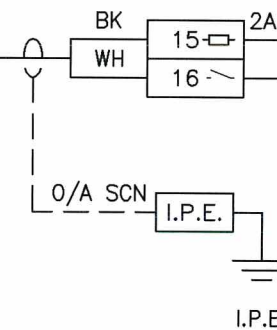CAB No. LMR-6133
TB LOC. FRONT RIGHT 2
TB No. LP0101-JND004-2SEE DRG. No.
3000-T-61-30-E-4744-14

P.S. LOC. LMR-6133: 10.15

0v +24V

CAB No. LMR-6133
TB No. AL01
TB TYPE P&F-MB-D016R-AKB-127733B
15CSYSTEM CABLE No.
FCS0701-01-01

X1A

CABINET	LC-6110
FCS No.	FCS0701 FCS1401
SYS TAG	001XY084
MOD TYPE	ADR541P
NODE	SLOT CHANNEL
12	1 15

SEE DRG. No.
3000-C06-101-01 Sht 181

LAYOUT DRAWING No. 3000-T-90-30-D-4118-01

GENERAL NOTES:

DRAWING NO.

REFERENCE DRAWING



SCALE N.T.S.

JOB No.

SAKHALIN ENERGY
INVESTMENT Co. LTD.FACILITY NAME:
PILTUN - ASTOKHSKOYE
FIELD
PLATFORM 'B'REV.
No.

DESCRIPTION

DATE
16.04.13PREP.
RDCHK'D
BLMAPP.
WC

SEIC

XA AS-BUILT FOR RU-6126

DRAWING TITLE:

INSTRUMENT LOOP DIAGRAM
300-001-XY-084

PROJECT NO.	ORIGIN	MODULE	DISCIPLINE	DOC. TYPE	SEQUENCE NO.	SHEET NO.	REVISION
3000	T	01	30	D	4000	03	XA