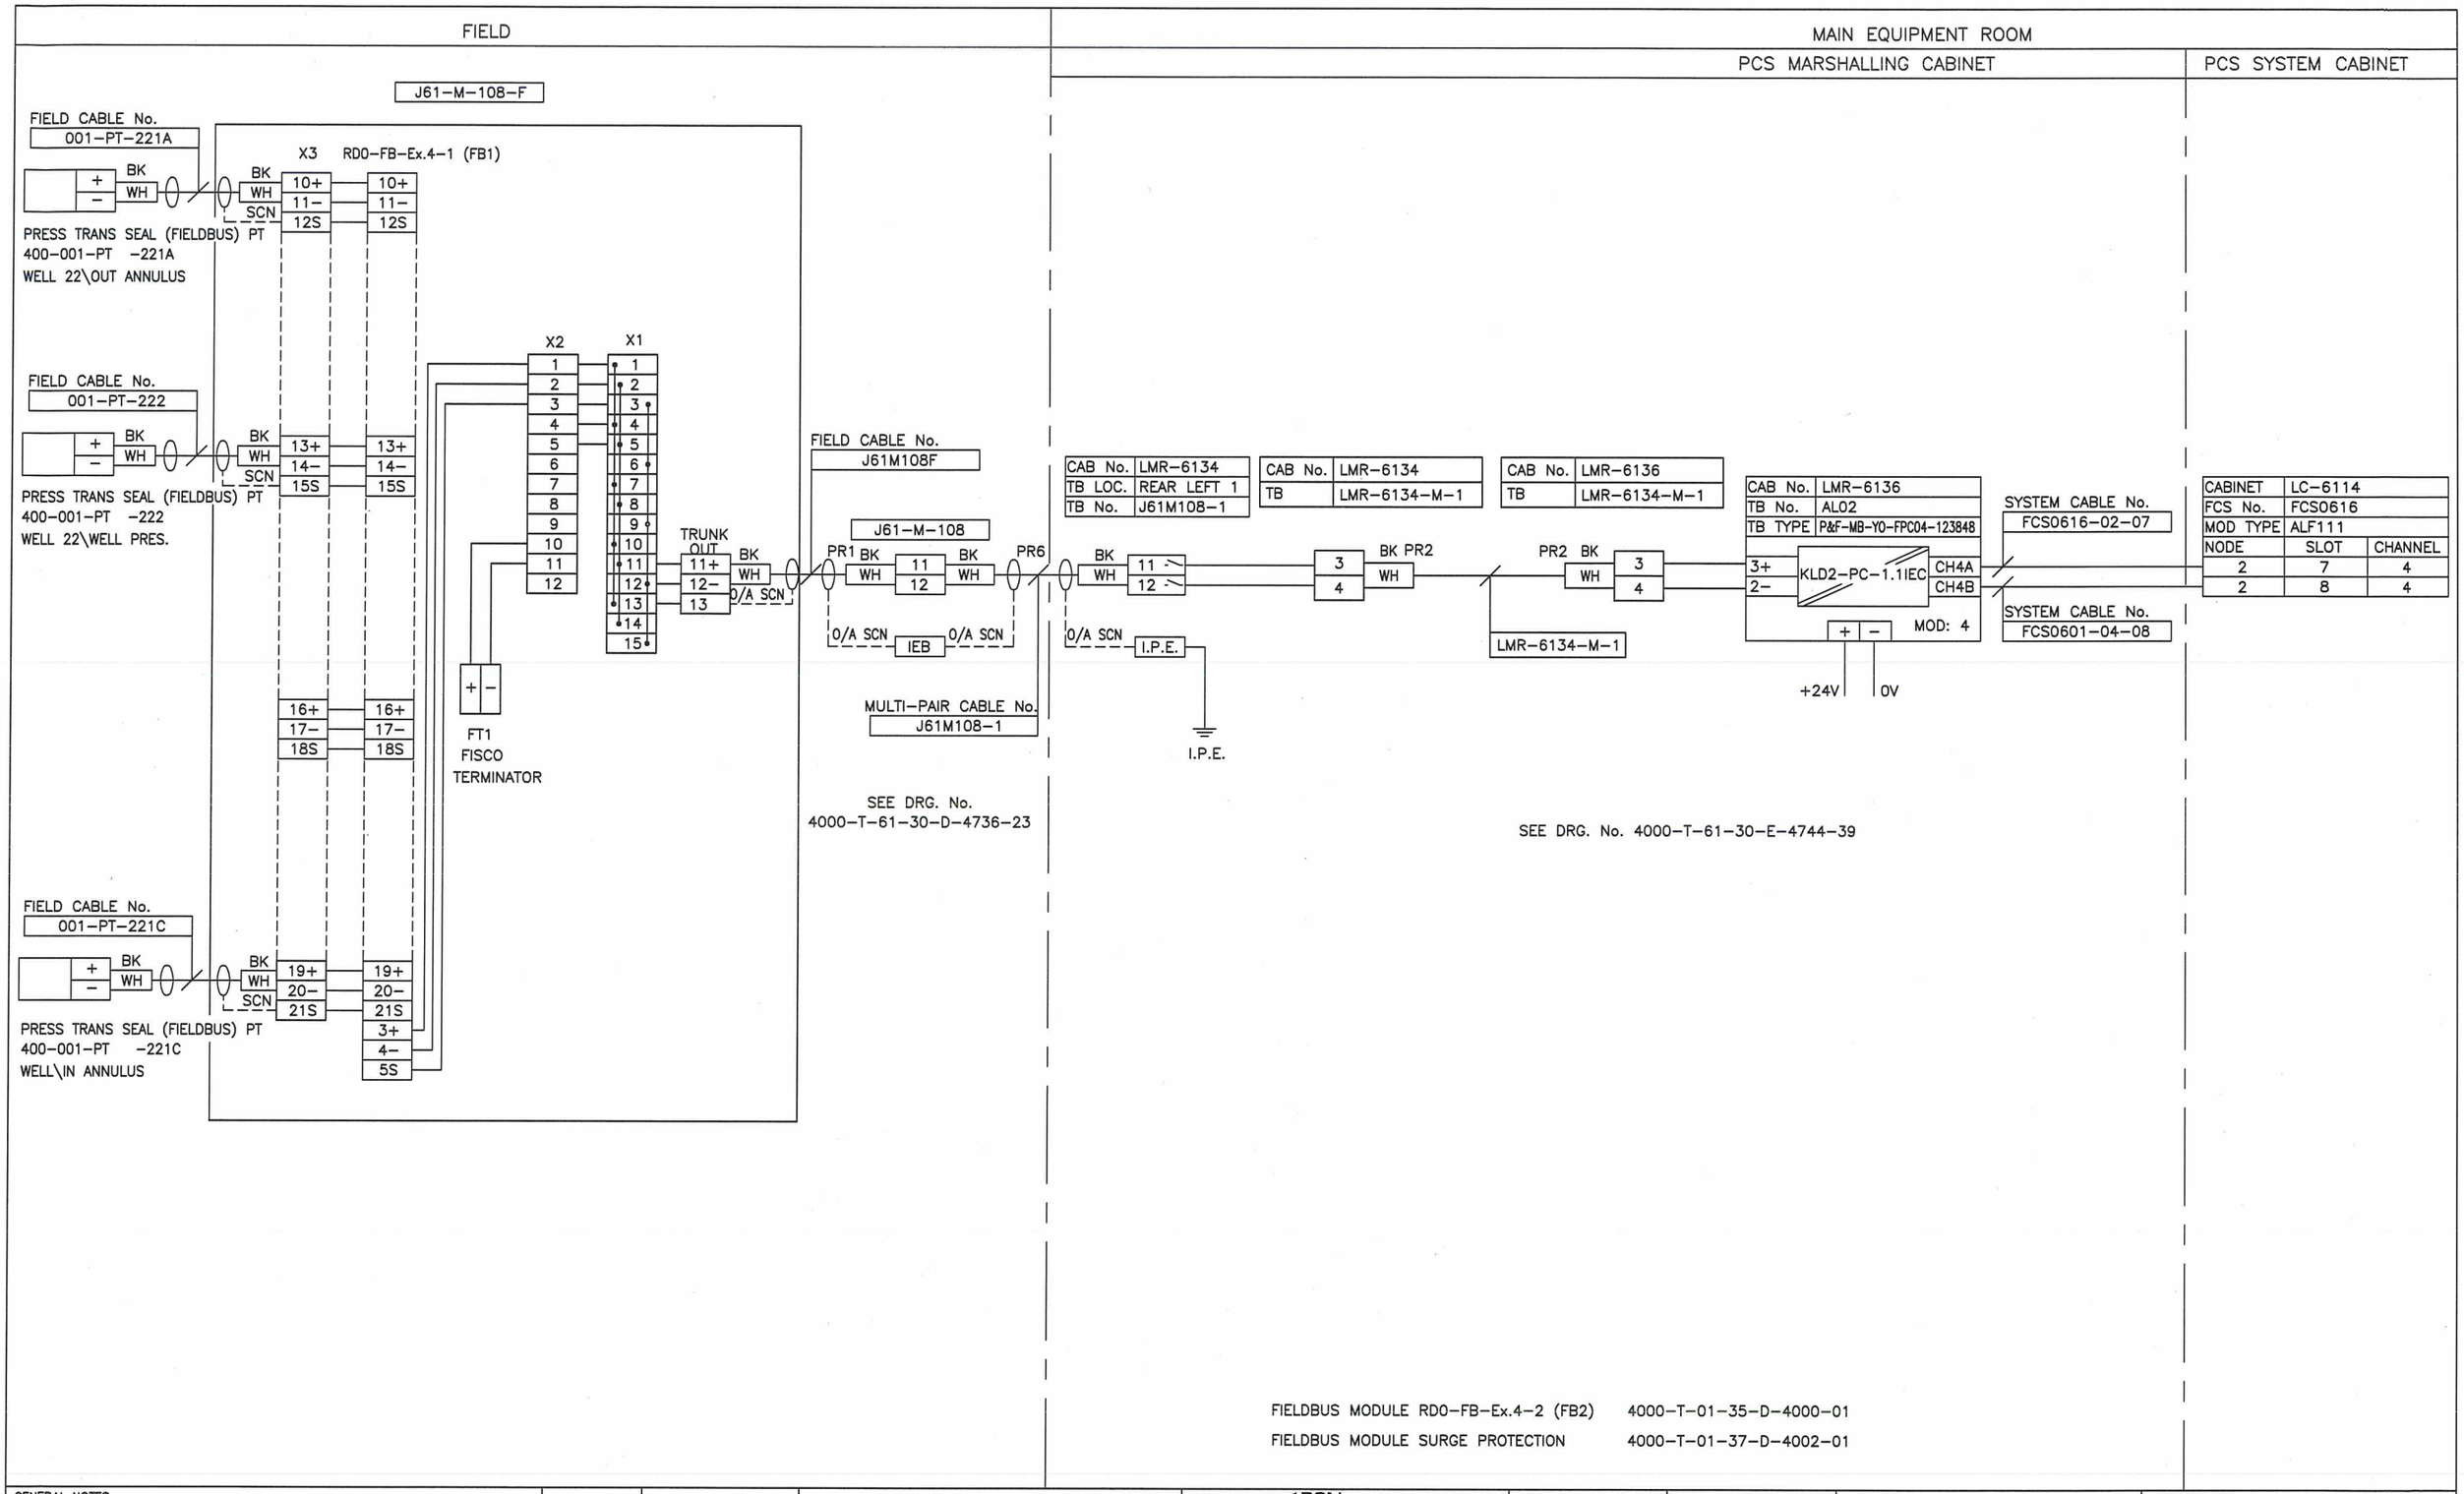

GENERAL NOTES:

PSN PROJECT	DRAWING NO.	REFERENCE DRAWING

REV. No.	DESCRIPTION	DATE	PREP.	CHK'D	APP.	SEIC
XB	AS-BUILT FOR RU-6091	19/02/14	RD	DF	DV	
XA	AS BUILT FOR RU-6091	05/11/12	SS	GLM	WC	

PSN

PSN PROJECT

SCALE

JOB No.

SAKHALIN ENERGY INVESTMENT CO. LTD.

FACILITY NAME: LUNSKOYE FIELD PLATFORM 'A' (LUN-A)

DRAWING TITLE: INSTRUMENT LOOP DIAGRAM 400-001-PT-221A/221C/222

PROJECT NO.	ORIGIN	MODULE	DISCIPLINE	DOC. TYPE	SEQUENCE NO.	SHEET NO.	REVISION
4000	T	01	34	D	4000	01	XB