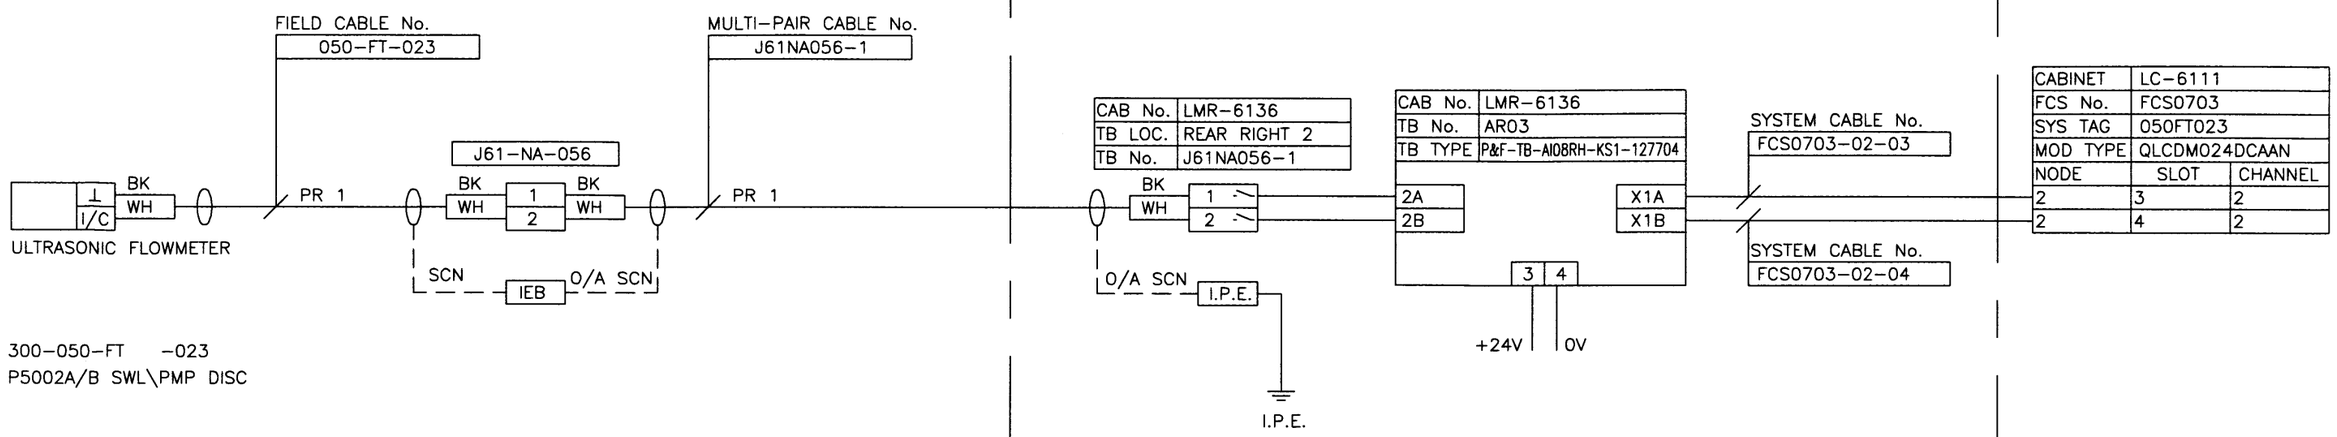

300-050-FT -023
P5002A/B SWL\PMP DISC

LINE No. 20"-WS50001-1382X
ASSOCIATED EQUIPMENT. NA
PEFS DRAWING No. 3000-T-50-08-D-8552-01

AS-BUILT

07 APR '09

LAYOUT DRAWING No. 3000-T-90-30-D-4109-01

REV	ISSUE DATE	DRAWN BY	DRAWN CHKD	ENGINEERING BY	ENGINEERING DISCP	ENGINEERING PROJ		SEEN BY SE	DESCRIPTION OF REVISION
XA	11/02/09	RnD	SIH/SON						AS-BUILT NO CHANGE
A	05/08/05	SM	GR		JET			EH	APPROVED FOR CONSTRUCTION

TITLE

INSTRUMENT LOOP DIAGRAM
300-050-F-023

amec

SAKHALIN ENERGY INVESTMENT CO. LTD.

FACILITY NAME
PILTUN ASTOKHSKOYE FIELD PLATFORM "PA - B"

PROJECT NO.	ORIGIN	MODULE	DISCIPLINE	DOC. TYPE	SEQUENCE NO.	SHEET NO.	REVISION
3000	T	50	30	D	4900	09	XA